

Downtown Knoxville Design Overlay District Certificate of Appropriateness

Name of Applicant: Rafik Hanna

Owner Contractor Architect Engineer Other

Date Filed: 9/2/10 Application accepted by: Michael Reynolds

Fee Amount: 50.00 Review Date: 9/15/10 File Number: 9-C-10-DT

SEP - 7 2010
 METROPOLITAN
 PLANNING COMMISSION

PRE-APPLICATION CONFERENCE Date Completed: _____

PROPERTY INFORMATION

Building or Project Name: _____

Street Address: 415 Gay Street

Parcel Identification Number(s): _____

PROJECT ARCHITECT/ENGINEER

PLEASE PRINT
 Name: Grand AS Four

Company: Astair Associate

Address: 9709 Dutchman Rd

City: Knoxville State: TN Zip: 37923

Telephone: 687-8015

Fax: _____

E-mail: _____

PROPERTY OWNER

PLEASE PRINT
 Name: RAFIK HANNA

Company: _____

Address: 415 Gay Street

City: Knoxville State: TN Zip: 37902

Telephone: 7552381

Fax: _____

E-mail: RAFIK.HANNA@AOL.COM

PROJECT CONTRACTOR

PLEASE PRINT
 Name: Grand AS Four

Company: _____

Address: _____

City: _____ State: _____ Zip: _____

Telephone: _____

Fax: _____

E-mail: _____

ACCOMPANYING MATERIALS
 Please see the reverse side of this form for a list of information required as part of this application.

FOR OFFICE USE ONLY

PROJECT INFORMATION

LEVEL 1: \$50

Minor Alteration of an Existing Building/Structure

Sign

LEVEL 2: \$100

Major Alteration of an Existing Building/Structure

Addition to an Existing Building/Structure

LEVEL 3: \$250

Construction of New Building/Structure

PROJECT CONTACT

All application-related correspondence should be directed to:

PLEASE PRINT
 Name: RAFIK HANNA

Company: _____

Address: 415 S. Gay Street

City: Knoxville State: TN Zip: 37910

Telephone: 7552381

Fax: _____

E-mail: _____

PROJECT 1



PROPOSED RESTURAN

415 S. GAY ST
KNOXVILLE, TN

OWNER:

RAFIK HAUNA

ENGINEER:
GRANT R. ASFOUR, P.E.

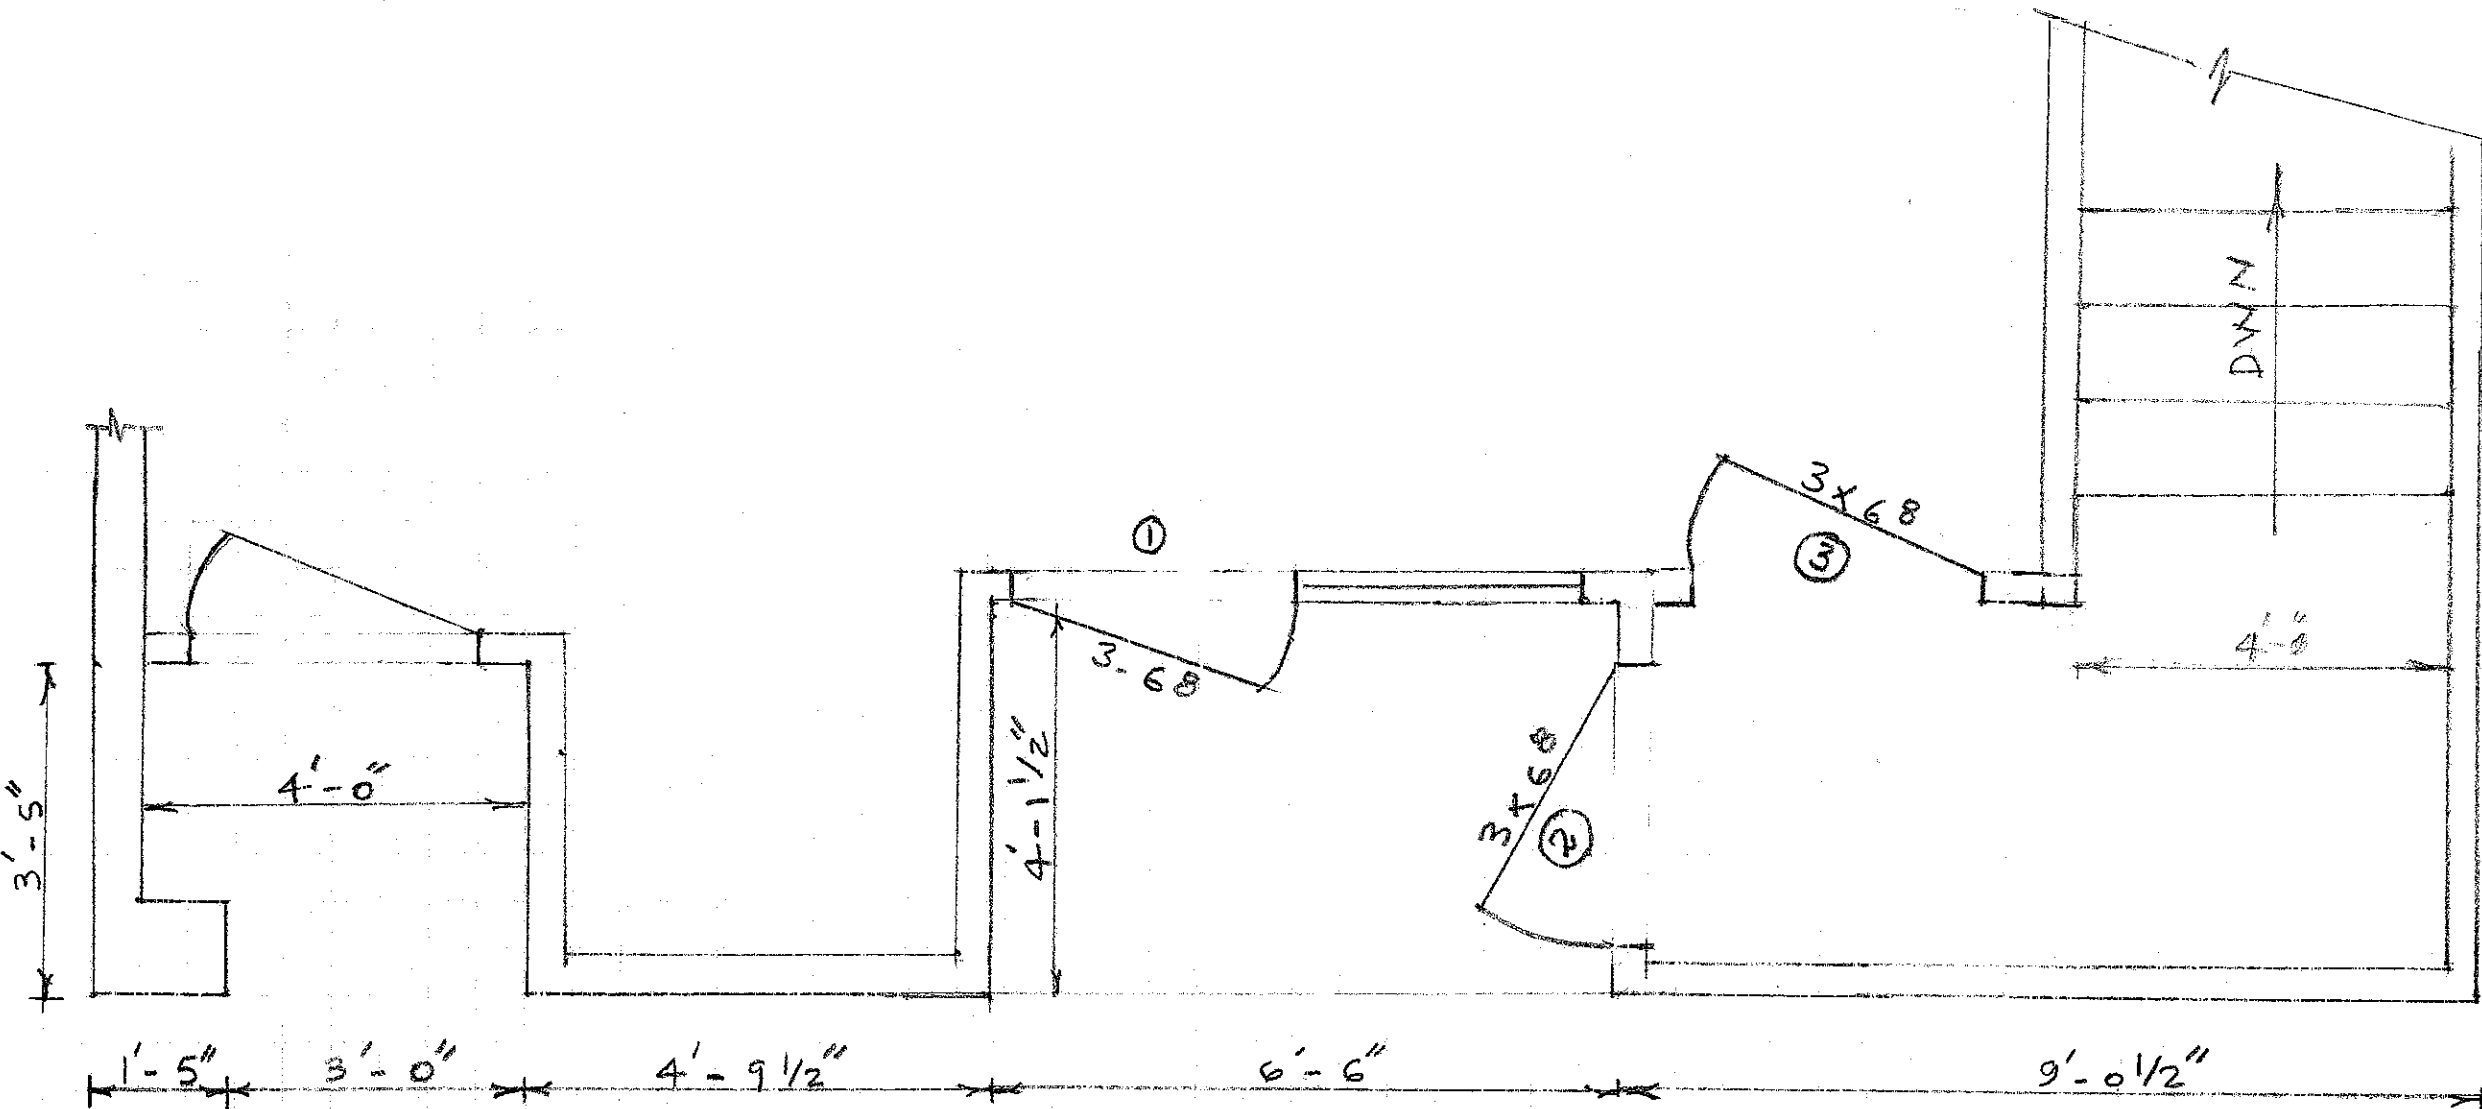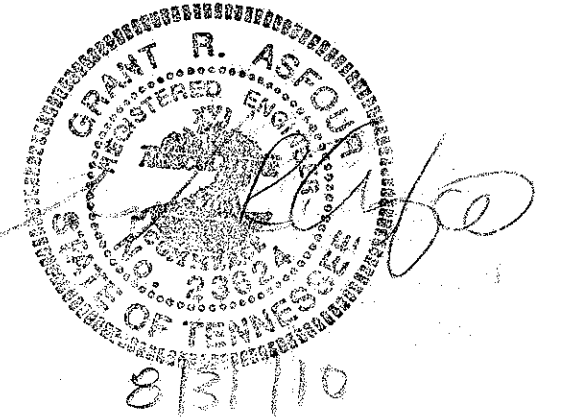

AS BUILT PARTIAL FLOOR PLAN

SCALE 1/2" = 1'-0"



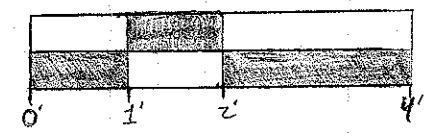


Photo 1

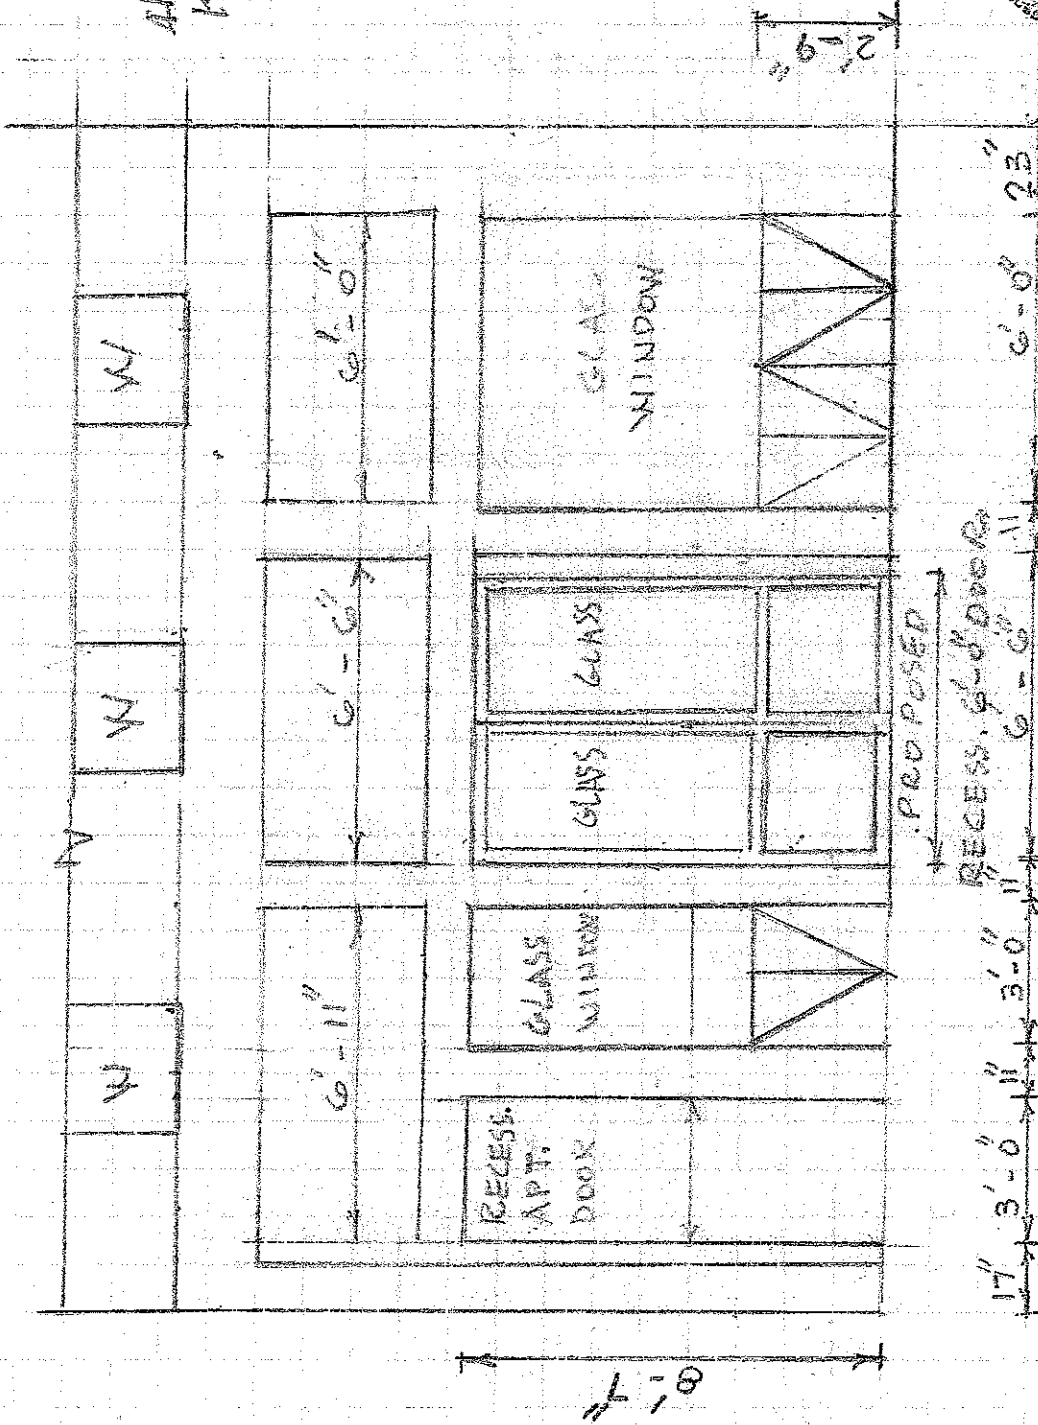

New exit door location

115 S. GAY ST
 KNOXVILLE
 T. N.

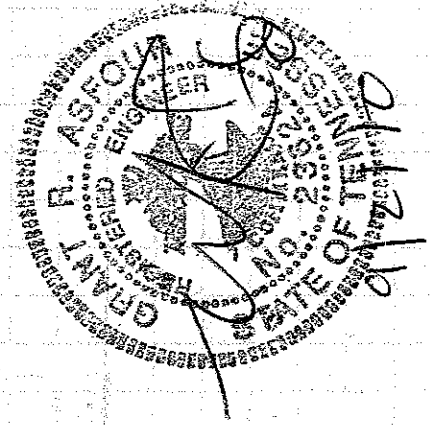

PARTIAL ELEVATION VIEW

1/4" = 1'-0"





As of 8/10/2010