

Report of Staff Recommendation

Tennessee Technology Corridor Development Authority

File Number: 8-A-20-TOA

Applicant: PELLISSIPPI INVESTORS

Request: BUILDING PERMIT

Meeting Date: 7/6/2020

Address: 2360 Cherahala Blvd.

Map/Parcel Number: 103 E A 01602

Location: East side of Cherahala Blvd. north of Hardin Valley Rd.

Existing Zoning: BP (Business and Technology) and TO (Technology Ovleray)

Proposed Zoning:

Existing Land Use: Offices

Proposed Land Use: National Transportation Research Center (remains the same)

Appx. Size of Tract: 15.17 acres

Accessibility: Cherahala Boulevard is a local road that transitions from a boulevard to a standard road in front

of this property. Pavement width ranges from 30.2 feet to 36.9 feet inside a 50-foot right-of-way

width.

Surrounding Zoning

and Land Uses:

North: BP (Business and Technology Park) / TO (Technology Overlay) - vacant land

South: CA (General Business) / TO (Technology Overlay) - Child day care center (approved in

May 2020)

East: BP (Business and Technology Park) / TO (Technology Overlay) - offices, a credit union, a

small medical office

West: BP (Business and Technology Park) / TO (Technology Overlay) - offices

Comments:

1) This is a request for the administrative approval of a revision to a development plan that was approved by the TTCDA on January 11, 2016 (12-B-15-TOB). The previous approval was for a storage building for the National Transportation Research Center (NRTC) facility at this location. 2) The applicant is proposing to modify the existing structure to include a new 16' x 12' garage door on the northwest façade. The door will be situated 28--10" from the portion of the structure that protrudes back from the main structure and will not be visible from the street. 3) Staff determined that this request complied with the requirements for administrative review

as outlined in the Knox County Zoning Ordinances.

Design Guideline Conformity:

This request complies with the TTCDA Design Guidelines.


Waivers and Variances


N/A


Requested:


Staff Recommendation:

APPLICATION APPROVED June 30, 2020, pursuant to Article 5, Section 5.90.11 (Revisions to Development Plans), Knox County Zoning Ordinance, and all relevant requirements of the Design Guidelines.

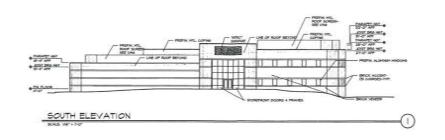

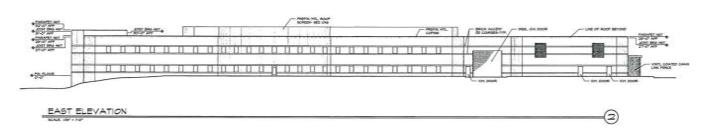

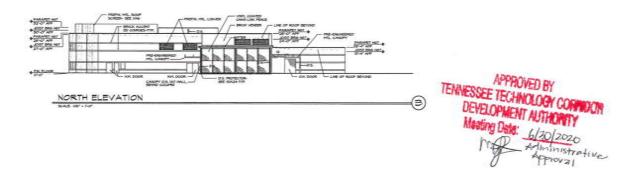

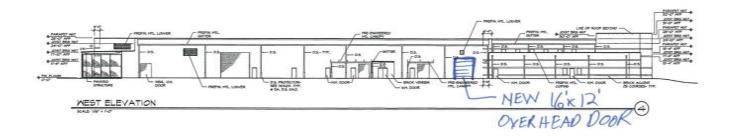

t u r e Brady Inc. O 0 Michael A r c h i




RECORD DRAWING




NATIONAL TRANSPORTATION RESEARCH CENTER

Brawing Title: PUTRON SERVICES

Date: 07/26/99 Down By: BDP. Comm. No. 47(25) Sheet: Sheet So. A7

 

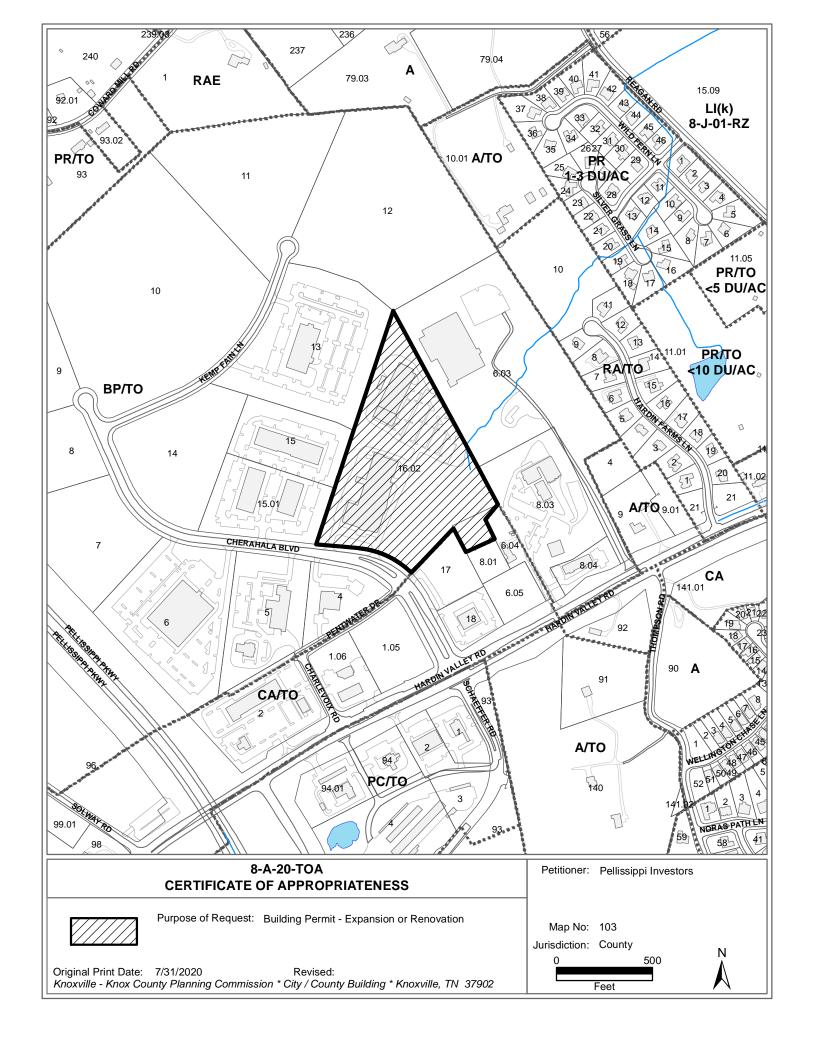



CERTIFICATE OF APPROPRIATENESS Name of Applicant: Pellissiff Investors Date Filed: 6-19-2020 Fee Paid: 150.00 File Number: 8-A-20-TOA

Map Number: 103EAO1602 Zoning District: BP/TO

Jurisdiction: ☐ City Cour	ncilmanic District County — Commission District
PROPERTY INFORMATION	
ADDRESS: 2360 CHERAHALA BLVD STREET NUMBER AND NAME GENERAL LOCATION: EAST OF PELLISSIPPI PARKWAY — NONTH OF HARIYN VALLEY ROAD PARCEL NUMBER(S): 103EA01602	
SIZE OF TRACT: 15: 17 196	
PURPOSE OF REQUEST □ BUILDING PERMIT — New Construction □ BUILDING PERMIT — Expansion or Renovation □ BUILDING PERMIT — Grading Plan □ REZONING From:	NOTE: Four (4) copies of all plan materials are required to process the application. Please check all that apply: □ DEVELOPMENT PLAN ☑ BUILDING ELEVATIONS ☑ FLOOR PLAN □ LANDSCAPE PLAN WITH SCHEDULE □ SIGNAGE PLAN □ OFF-STREET PARKING PLAN □ OTHER:
APPLICATION CORRESPONDENCE — All correspondence relating to this application should be sent to: PLEASE PRINT Name: JOHN PATIESON Phone: 865-584-0999 Fax: Mailing Address: 299 N. WEISGARBER ROAD KNOXVILLE, TN 37919 APPLICATION AUTHORIZATION APPLICATION AUTHORIZATION APPLICATION AUTHORIZATION Application should be sent to:	
APPLICATION AUTHORIZATION — I hereby certify that I am the authorized applicant, representing ALL property owners involved in this request or holders of option on same, whose signatures are included on the back of this form. Signature: Phone: Phone: Fax:	
APPLICATION ACCEPTANCE — Staff Member who accepted this application:	



Certificate of Appropriateness For a Building Permit

Tennessee Technology Corridor Development Authority

(Administrative Approval)

On June 30, 2020, the Tennessee Technology Corridor Development Authority, hereinafter referred to as the Authority, did grant to Pellissippi Investors, hereinafter referred to as the Applicant, on its application filed on June 19, 2020 with Application No. 8-A-20-TOA, this Certificate of Appropriateness for the following described property, 2360 Cherahala Blvd. / Parcel ID 103 E A 01602. This Certificate of Appropriateness is granted to the Applicant for the purpose of a Building Permit. The Applicant agrees that it will comply with all base zoning requirements, all Technology Overlay Zone requirements, the Design Guidelines and the Comprehensive Development Plan in its use of this property, unless specifically varied or altered by the Authority.

This Certificate of Appropriateness will automatically expire two years from the date of the affirmative vote of this Certificate, unless an extension of the Certificate is granted by the Authority upon the request of the Applicant, if construction of the structure or structures on the property has not reached fifty percent (50%) of completion at the end of that two year period.

The Applicant does hereby agree that staff and/or members of the Knox County governmental entities, or the Authority, shall have access to the property at reasonable times to inspect the same for compliance with the requirements of state and local laws and this Certificate of Appropriateness.

The structure or structures to be erected on this property will be erected according to the approved and accepted plans and specifications attached to this Certificate as Attachment No. One, and any changes thereto approved and accepted by the Applicant and the Authority.

APPLICATION APPROVED June 30, 2020, pursuant to Article 5, Section 5.90.11 (Revisions to Development Plans), Knox County Zoning Ordinance, and all relevant requirements of the Design Guidelines.

By its signature hereunto, the Applicant binds itself to all terms and conditions hereof, both for itself, its heirs, and its successors in interest.

TENNESSEE TECHNOLOGY CORRIDOR DEVELOPMENT AUTHORITY

BY:

Chair

Attested to by